

[« Back to Availabilities Summary](#)

8413 FALLBROOK

1ST FLOOR



SIZE:

6,265 RSF (storage space)

TOTAL BUILDING SF:

31,823 RSF

ASKING RATE:


\$2.15 PSF

FIBER CONNECTIVITY PROVIDERS:

AT&T and Verizon FIOS

PARKING RATIO:

5/1000

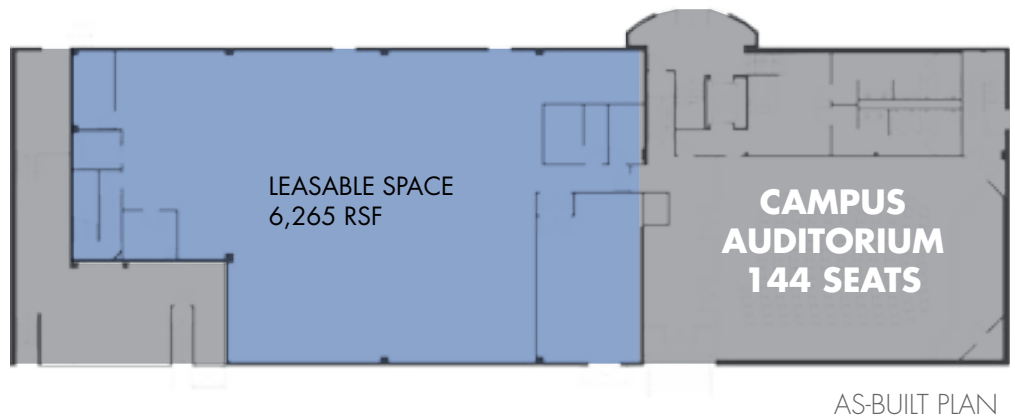

AS-BUILT PLAN

