

[« Back to Availabilities Summary](#)

**8413  
FALLBROOK**

**1ST FLOOR**




**SIZE:**  
5,149 RSF (storage space)

**ASKING RATE:**  
\$2.15 PSF

**FIBER CONNECTIVITY PROVIDERS:**  
AT&T and Verizon FIOS

**PARKING RATIO:**  
6/1000

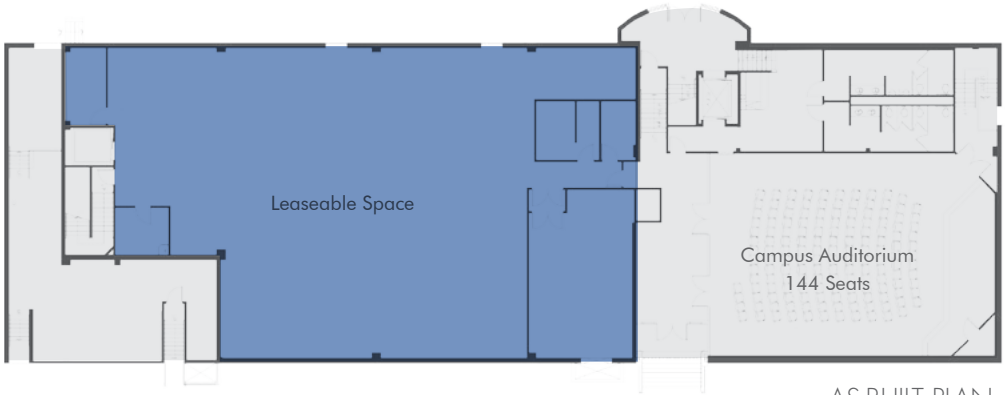

AS-BUILT PLAN



© 2016 CBRE, Inc. This information has been obtained from sources believed reliable. We have not verified it and make no guarantee, warranty or representation about it. Any projections, opinions, assumptions or estimates used are for example only and do not represent the current or future performance of the property. You and your advisors should conduct a careful, independent investigation of the property to determine to your satisfaction the suitability of the property for your needs.