

[« Back to Availabilities Summary](#)

8521 FALLBROOK

3RD FLOOR




SIZE:
41,607 RSF (divisible)

ASKING RATE:
\$2.15 PSF

FIBER CONNECTIVITY PROVIDERS:
AT&T and Verizon FIOS

PARKING RATIO:
6/1000

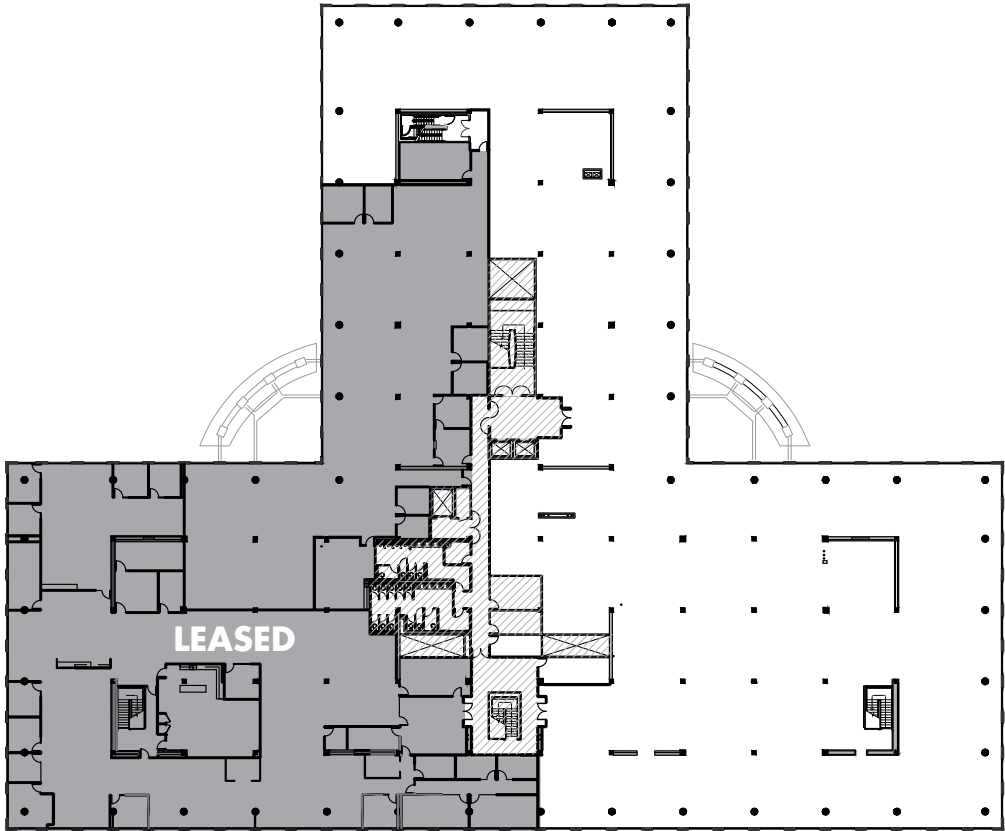

AS-BUILT PLAN



© 2016 CBRE, Inc. This information has been obtained from sources believed reliable. We have not verified it and make no guarantee, warranty or representation about it. Any projections, opinions, assumptions or estimates used are for example only and do not represent the current or future performance of the property. You and your advisors should conduct a careful, independent investigation of the property to determine to your satisfaction the suitability of the property for your needs.