

8521 FALLBROOK

[« Back to Availabilities Summary](#)

SUITE 150




SIZE:
6,884 RSF

TOTAL BUILDING SF:
160,498 RSF

ASKING RATE:
\$2.35 PSF

FIBER CONNECTIVITY PROVIDERS:
AT&T and Verizon FIOS

PARKING RATIO:
6/1000

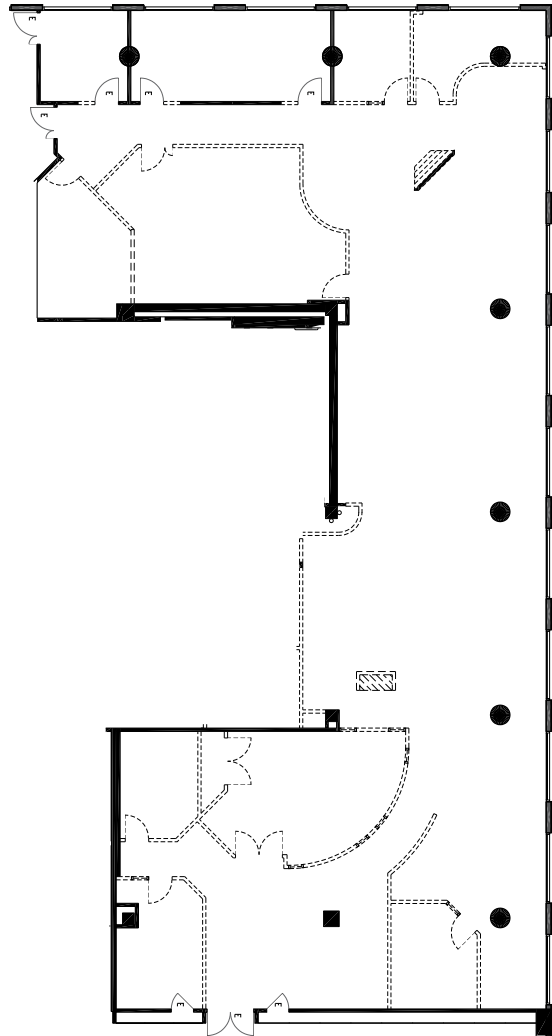

AS-BUILT PLAN

