

**8521
FALLBROOK**

[« Back to Availabilities Summary](#)

SUITE 220




SIZE:
1,417 RSF

ASKING RATE:
\$2.35 PSF

FIBER CONNECTIVITY PROVIDERS:
AT&T and Verizon FIOS

PARKING RATIO:
6/1000

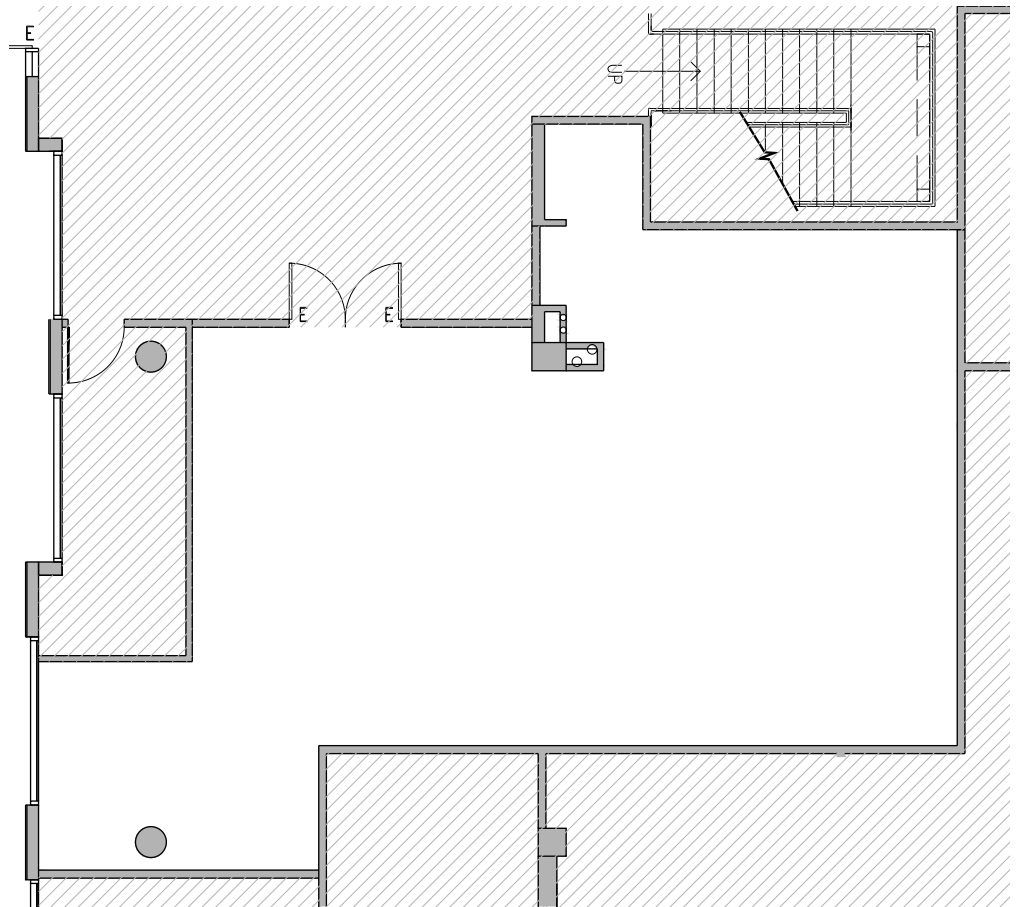

AS-BUILT PLAN

